Case 10946A-14

10411

10411 Aquila Ave

Certificate of Survey

For:
ORRIN E. THOMPSON CONSTRUCTION CORP.

C. R. WINDEN & ASSOCIATES, INC.
LAND SURVEYORS Tel. 645-3646
1381 EUSTIS ST., ST. PAUL, MINN. 55108

Notice: This is NOT a survey of the "as built" condition of the property, and the City of Bloomington DOES NOT warrant or represent that this survey accurately reflects the location, elevation, or condition of any of the features depicted.

Gar. Floor El. = 799.3
Basmnt Floor El. = 796.8

ELEVATIONS O.K. FOR DRAINAGE
SHALL BE GRADED TO DI...
WAY OF DRAINAGE EASEME...
DATE 7-5-77 BY 662

= Boat and trailer Storage area

N

Scale 1" = 30'
⊙ Denotes Iron

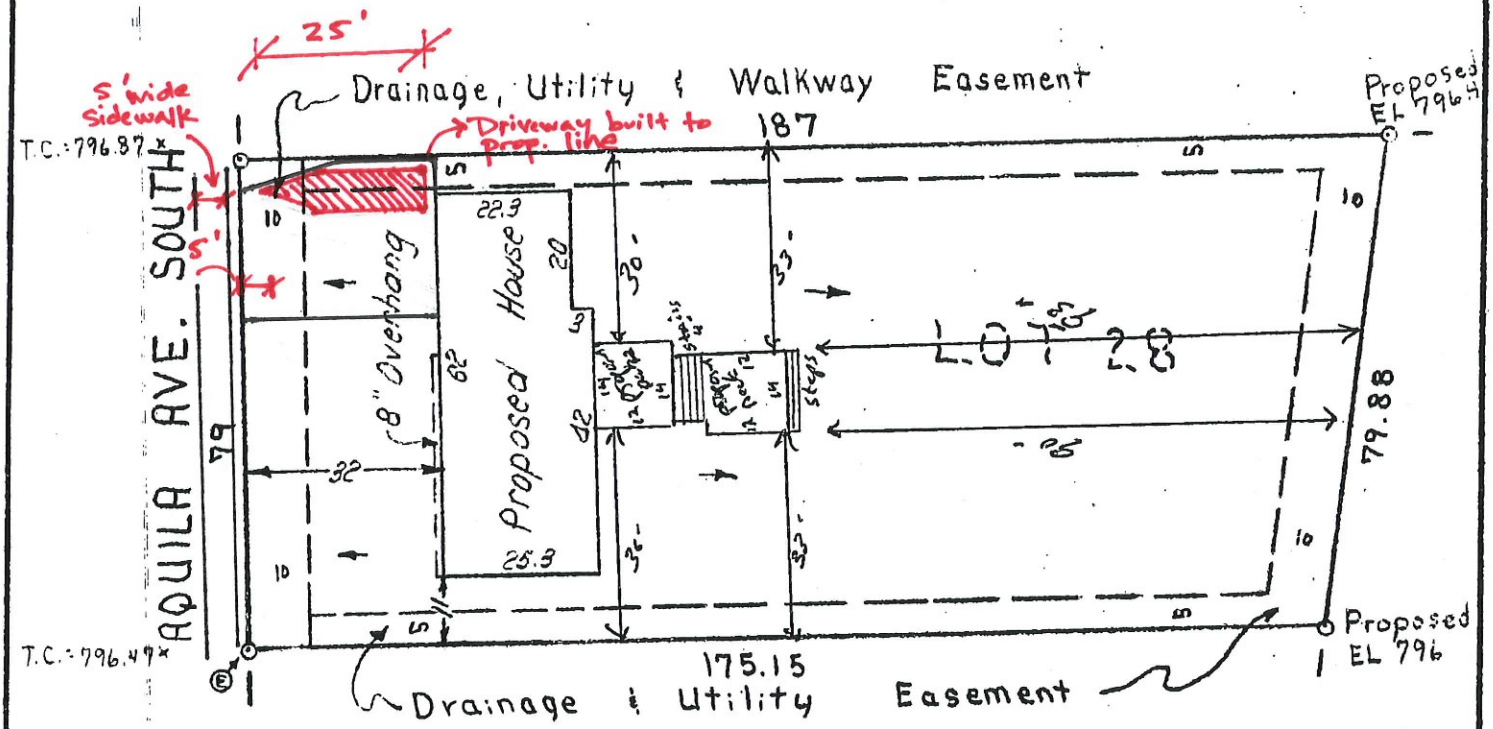

#707531
Dec 7-15-97

Lot 28, Block 9, Countryside West First Addition, Hennepin County, Minnesota

WE HEREBY CERTIFY THAT THIS IS A TRUE AND CORRECT REPRESENTATION OF A SURVEY OF THE BOUNDARIES OF THE LAND ABOVE DESCRIBED AND OF THE LOCATION OF ALL BUILDINGS, IF ANY, THEREON, AND ALL VISIBLE ENCROACHMENTS, IF ANY, FROM OR ON SAID LAND.

Dated this 20th day of June A.D. 1977 C. R. WINDEN & ASSOCIATES, INC.

10411 Aquila Avenue South

by [signature]
Surveyor, Minnesota Registration No. 7786

22705B1